Modernist classic.

2121 PONCE

10th Floor: 13,509 s.f.

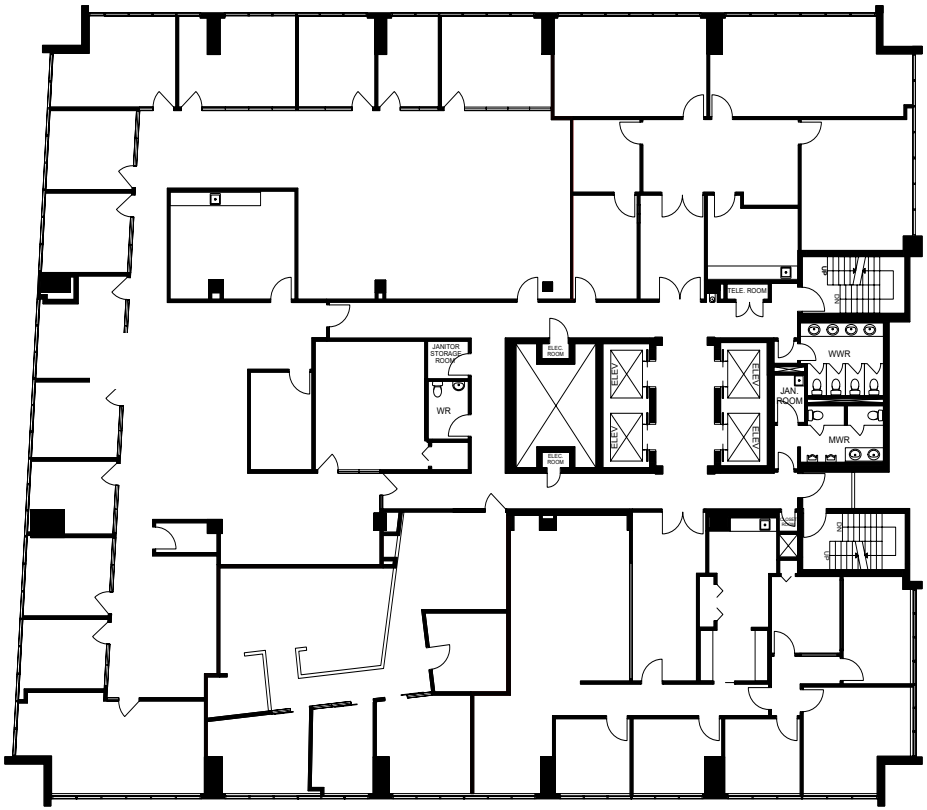

Leasing contacts

Doug Okun
+1 305 960 8444
doug.okun@jll.com

Steven Hurwitz
+1 305 960 8441
steven.hurwitz@jll.com

JLL®

© 2025 Jones Lang LaSalle Brokerage, Inc., a licensed real estate broker. All rights reserved. All information contained herein is from sources deemed reliable; however, no representation or warranty is made to the accuracy thereof.